


Proposed Tavern Layout Plan – 1527 Idylwyld Drive North

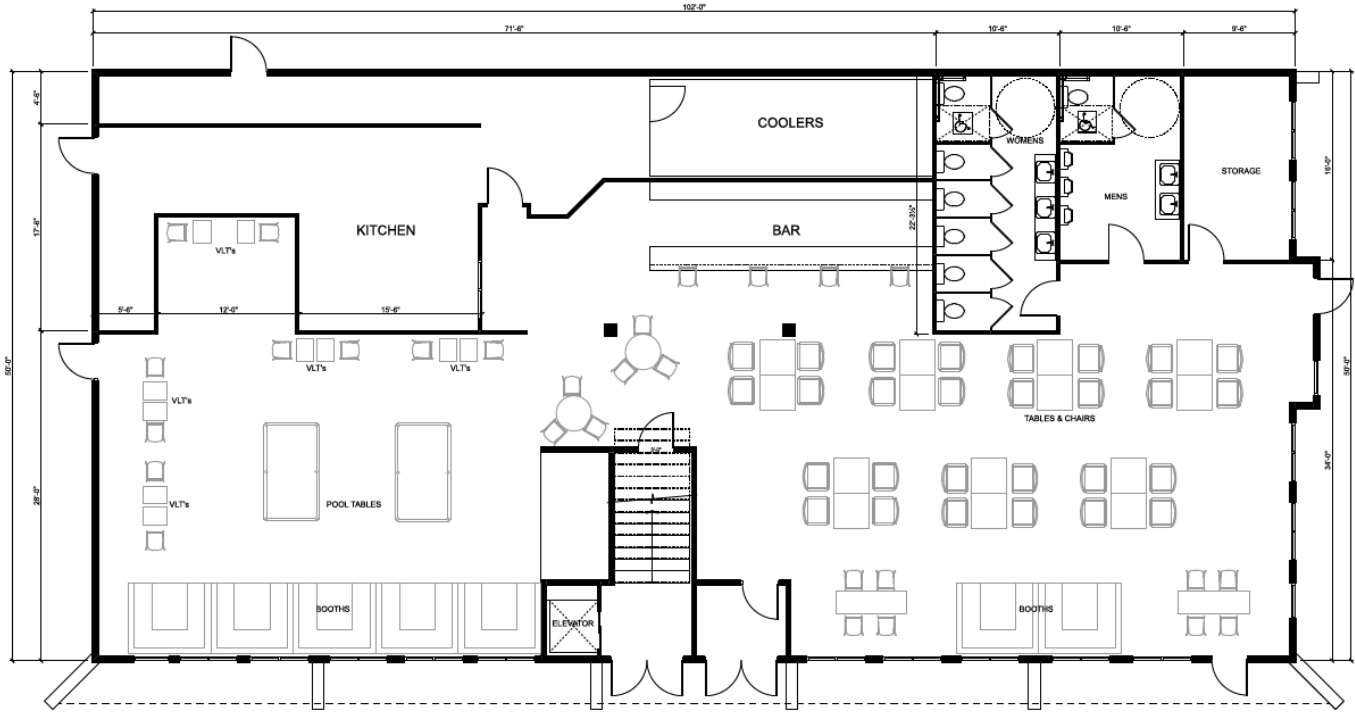

MAIN FLOOR PLAN - AS BUILT
SCALE: 1/8" = 1'-0"